


REEF DEVELOPMENT OF HAWAII, INC.

P.O. Box 1189
 KIHEI, HAWAII 96753
 Office: (808) 871-8888 FAX (808) 877-5262

AS-BUILT

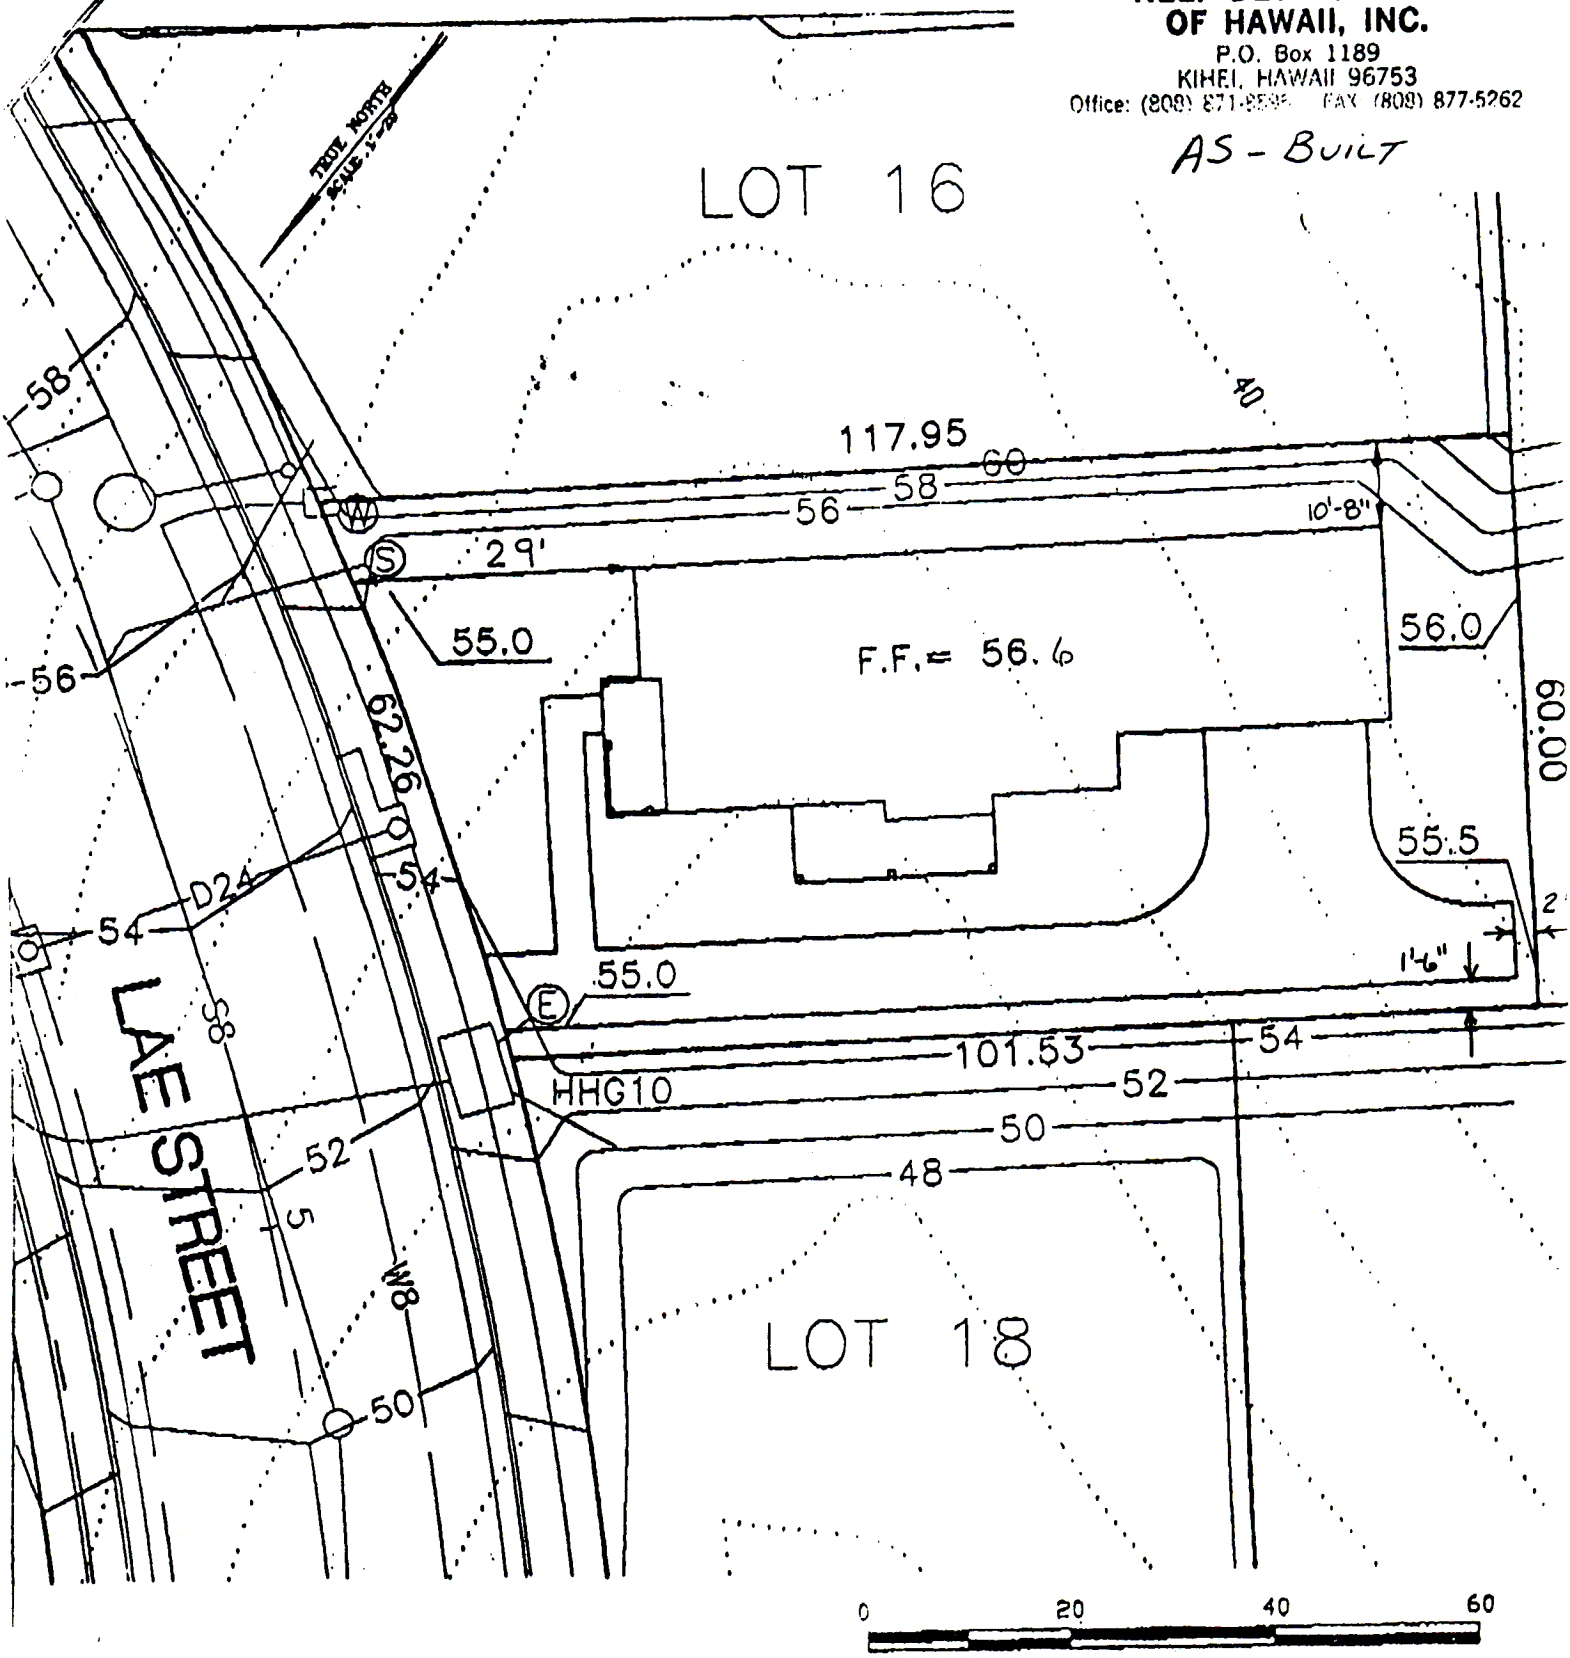

Note: This plot plan is intended to show only the approximate location of the home, utilities, and drainage contours, and should not be used by the buyer for any other purpose. The buyer should independently verify the precise location of utilities and drainage contours before performing any work that may affect the utilities or drainage for this property.

Plot Plan For Lot: 17

House Color:	Model No.: 1278
House Trim Color:	File Plan Lot No.:
Roof Color:	Truss:
Other:	Enclosure Lot No.:
	Lot Size (Sq. Ft.): 6537

⊘ No Access Permitted ⊘ St. Light Std.