


B910672

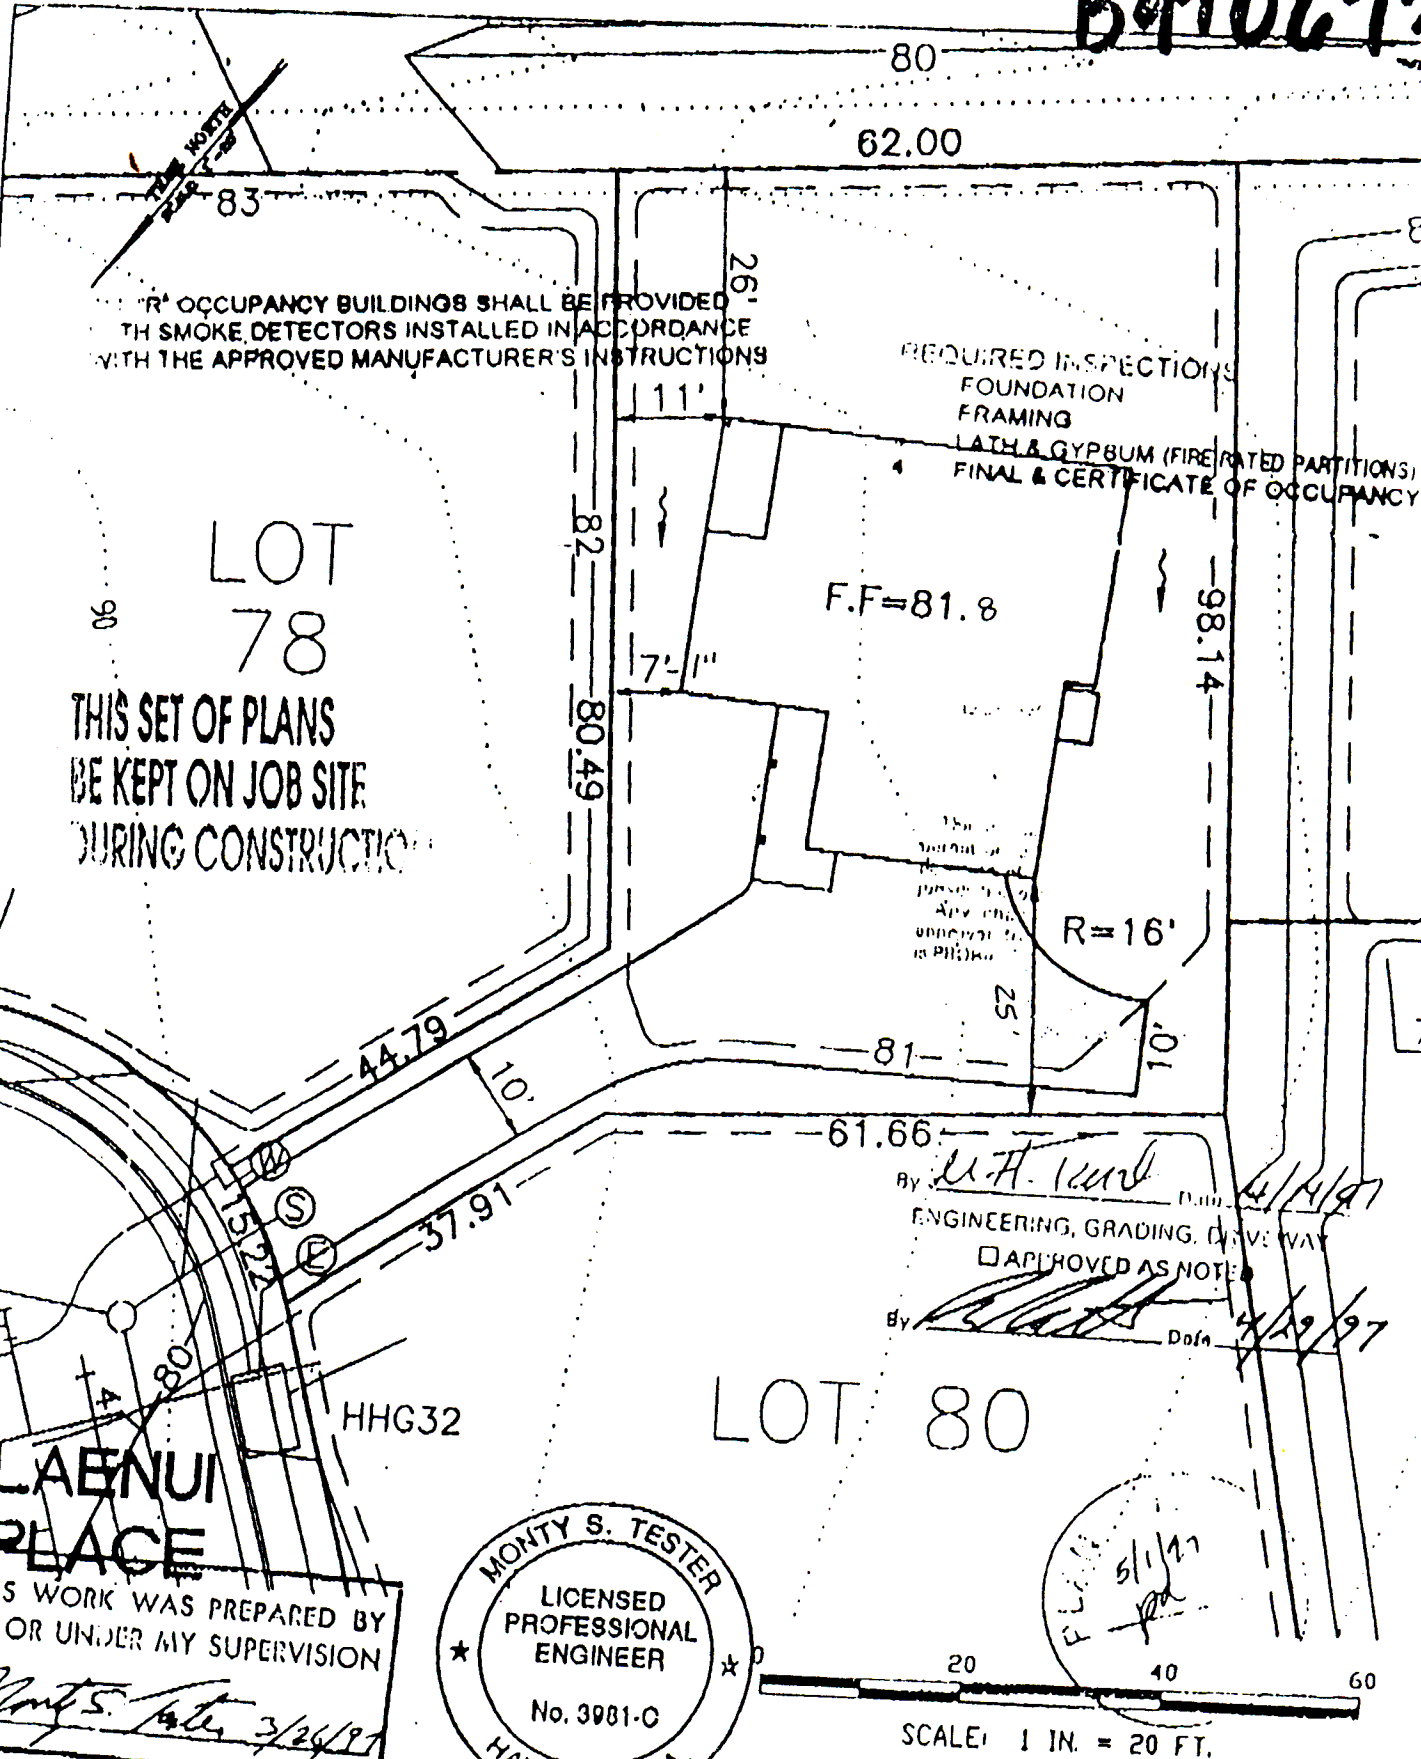

10' OCCUPANCY BUILDINGS SHALL BE PROVIDED WITH SMOKE DETECTORS INSTALLED IN ACCORDANCE WITH THE APPROVED MANUFACTURER'S INSTRUCTIONS

REQUIRED INSPECTIONS:
 FOUNDATION
 FRAMING
 LATH & GYPSUM (FIRE RATED PARTITIONS)
 FINAL & CERTIFICATE OF OCCUPANCY

LOT 78
 THIS SET OF PLANS
 BE KEPT ON JOB SITE
 DURING CONSTRUCTION

By *M.H. Tester* Date *4/14/97*
 ENGINEERING, GRADING, & SURVEYING
 APPROVED AS NOTED
 By *[Signature]* Date *4/19/97*

LAENUI PLACE
 THIS WORK WAS PREPARED BY ME OR UNDER MY SUPERVISION
Monty S. Tester 3/24/97

MONTY S. TESTER
 LICENSED PROFESSIONAL ENGINEER
 No. 3981-C
 HAWAII, U.S.A.

20 40 60
 SCALE: 1 IN. = 20 FT.

Note: This plot plan is intended to show only the approximate location of the home, utilities, and drainage buyer for any other purpose. The buyer should independently verify the precise location of utilities or work that may affect the utilities or drainage for this property.

Plot Plan For Lot: 79

House Color:	Model No.: 1600
House Trim Color:	File Plan Lot No.:
Roof Color:	T.M.K.:
Other:	Brochure Lot No.:

REEF DEVELOPMENT OF HAWAII, INC.
 P.O. Box 1189
 KIHAI, HAWAII 96753
 Office: (808) 871-8595 FAX: (808) 877-8000

AS-BUILT