





NOTE:
THE CONTRACTOR SHALL PRESENT A PHASING PLAN TO ALLOW NOT MORE THAN 15 ACRES OPEN FOR GRADING AT ONE TIME. THE PLAN SHALL INCLUDE SPECIFIC MEASURES FOR SOIL STABILIZATION IN PLACE BEFORE AN AREA CAN BE CONSIDERED CLOSED AND BEFORE ANOTHER AREA CAN COMMENCE GRUBBING AND GRADING. THE PHASING PLAN SHALL BE DISCUSSED AT THE PRE-CONSTRUCTION CONFERENCE WITH LAND USE AND CODES ADMINISTRATION.

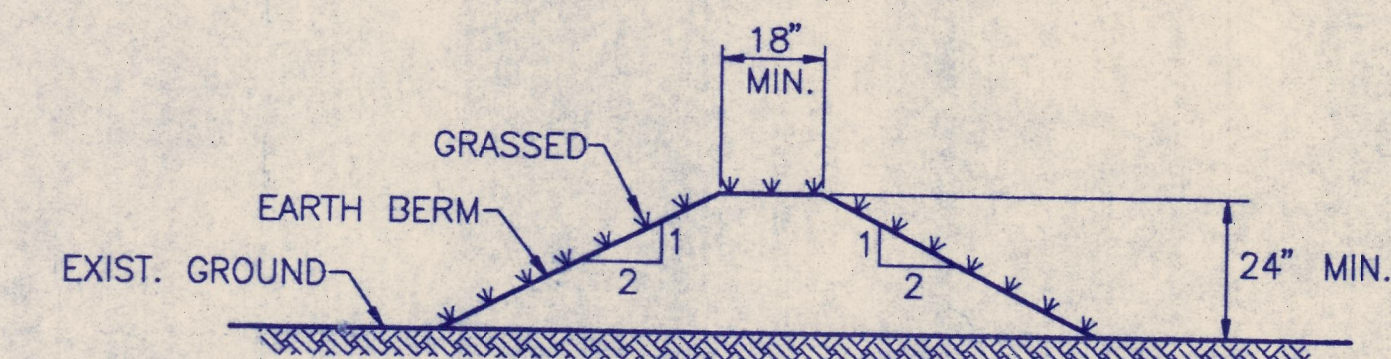

TYPICAL EARTH BERM
SCALE: NONE

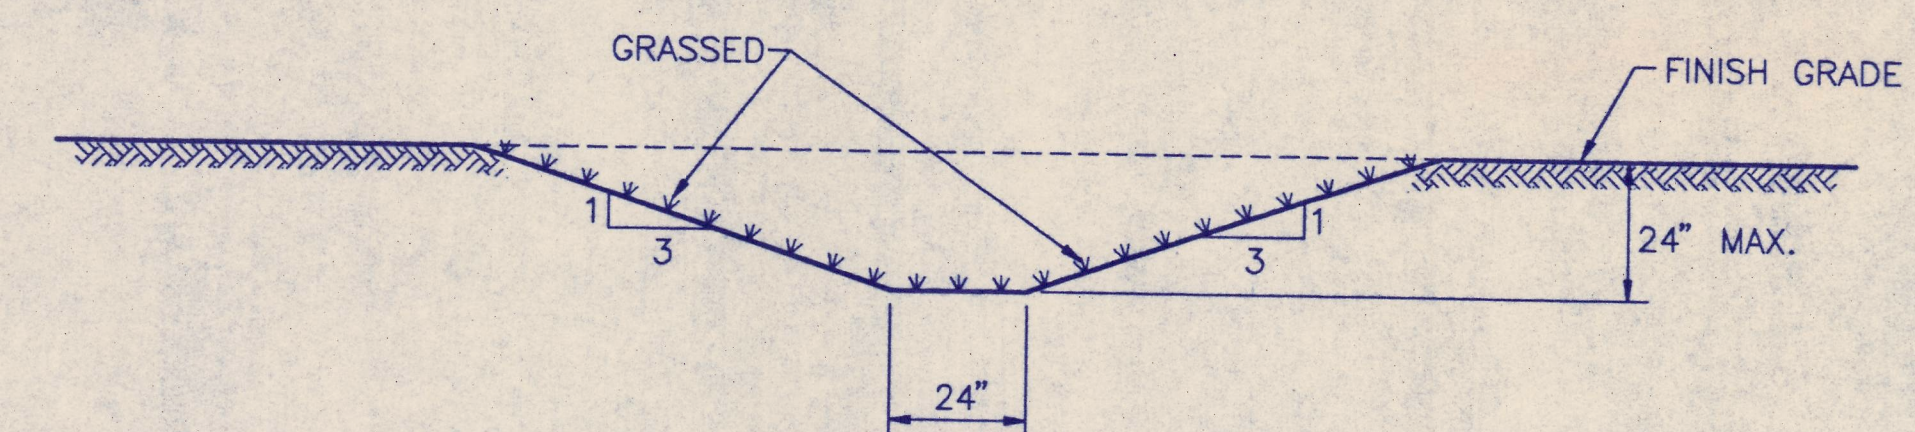


TYPICAL DIVERSION SWALE
SCALE: NONE



EROSION CONTROL PLAN
SCALE: 1"=100'

RECORD DRAWINGS
INFORMATION SHOWN WAS PROVIDED BY THE CONTRACTOR AND MAY NOT BE ACCURATE. THE USERS OF THIS DRAWING SHALL BE RESPONSIBLE TO VERIFY ITS ACCURACY.
DATE: 5/2/99

DATE: 12/22/94
SCALE: AS SHOWN
DESIGN BY: JP
DRAWN BY: JN
CHECKED BY: B.R.T.

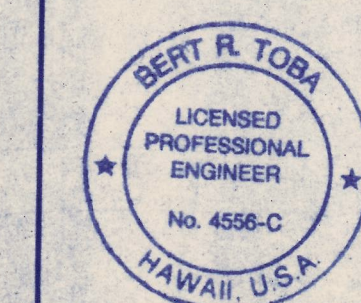

THIS WORK WAS PREPARED BY ME OR UNDER MY SUPERVISION

REPLACED 30MH W/CATCH BASIN PER D.O.T. COMMENTS.	6/10/95
ADDENDUM #3 SLOPE STABILIZATION WALL DELETED	5/1/95
REVISIONS AFTER BID	4/24/95
ADDENDUM #3	4/24/95

SATO & ASSOCIATES, INC.
CONSULTING ENGINEERS • CIVIL & STRUCTURAL
HONOLULU, OAHU, HAWAII • WAILUKU, MAUI, HAWAII

MAKANA SUBDIVISION
T.M.K.: 2-5-05: POR. 21
PAIA, HAMAKUPOKO, MAUI, HAWAII

EROSION CONTROL PLAN

APPROVED:	APPROVED:
DATE	DATE
DATE	DATE