

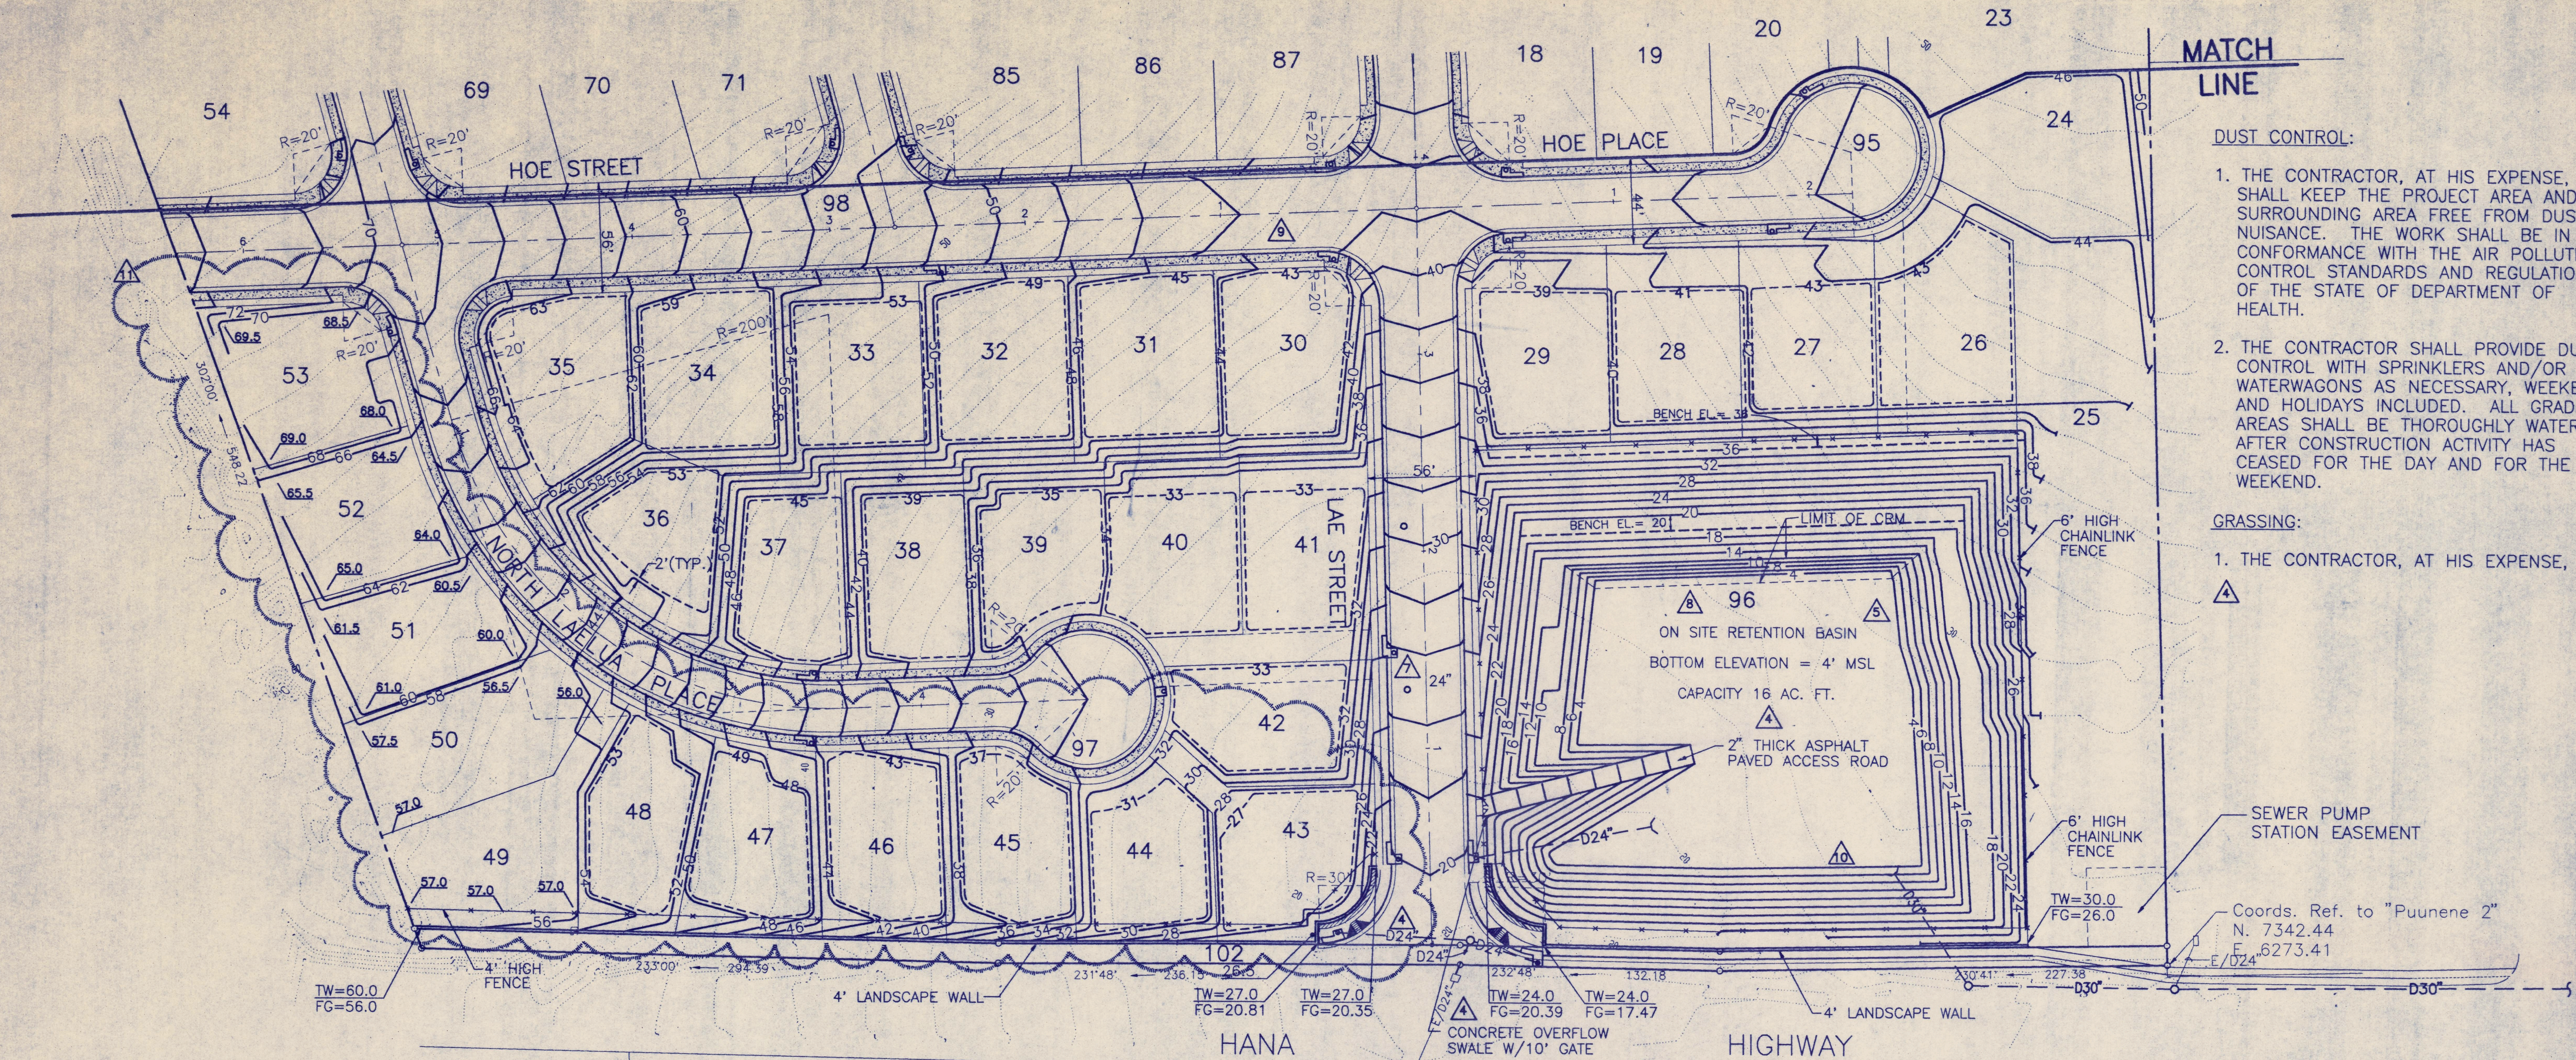
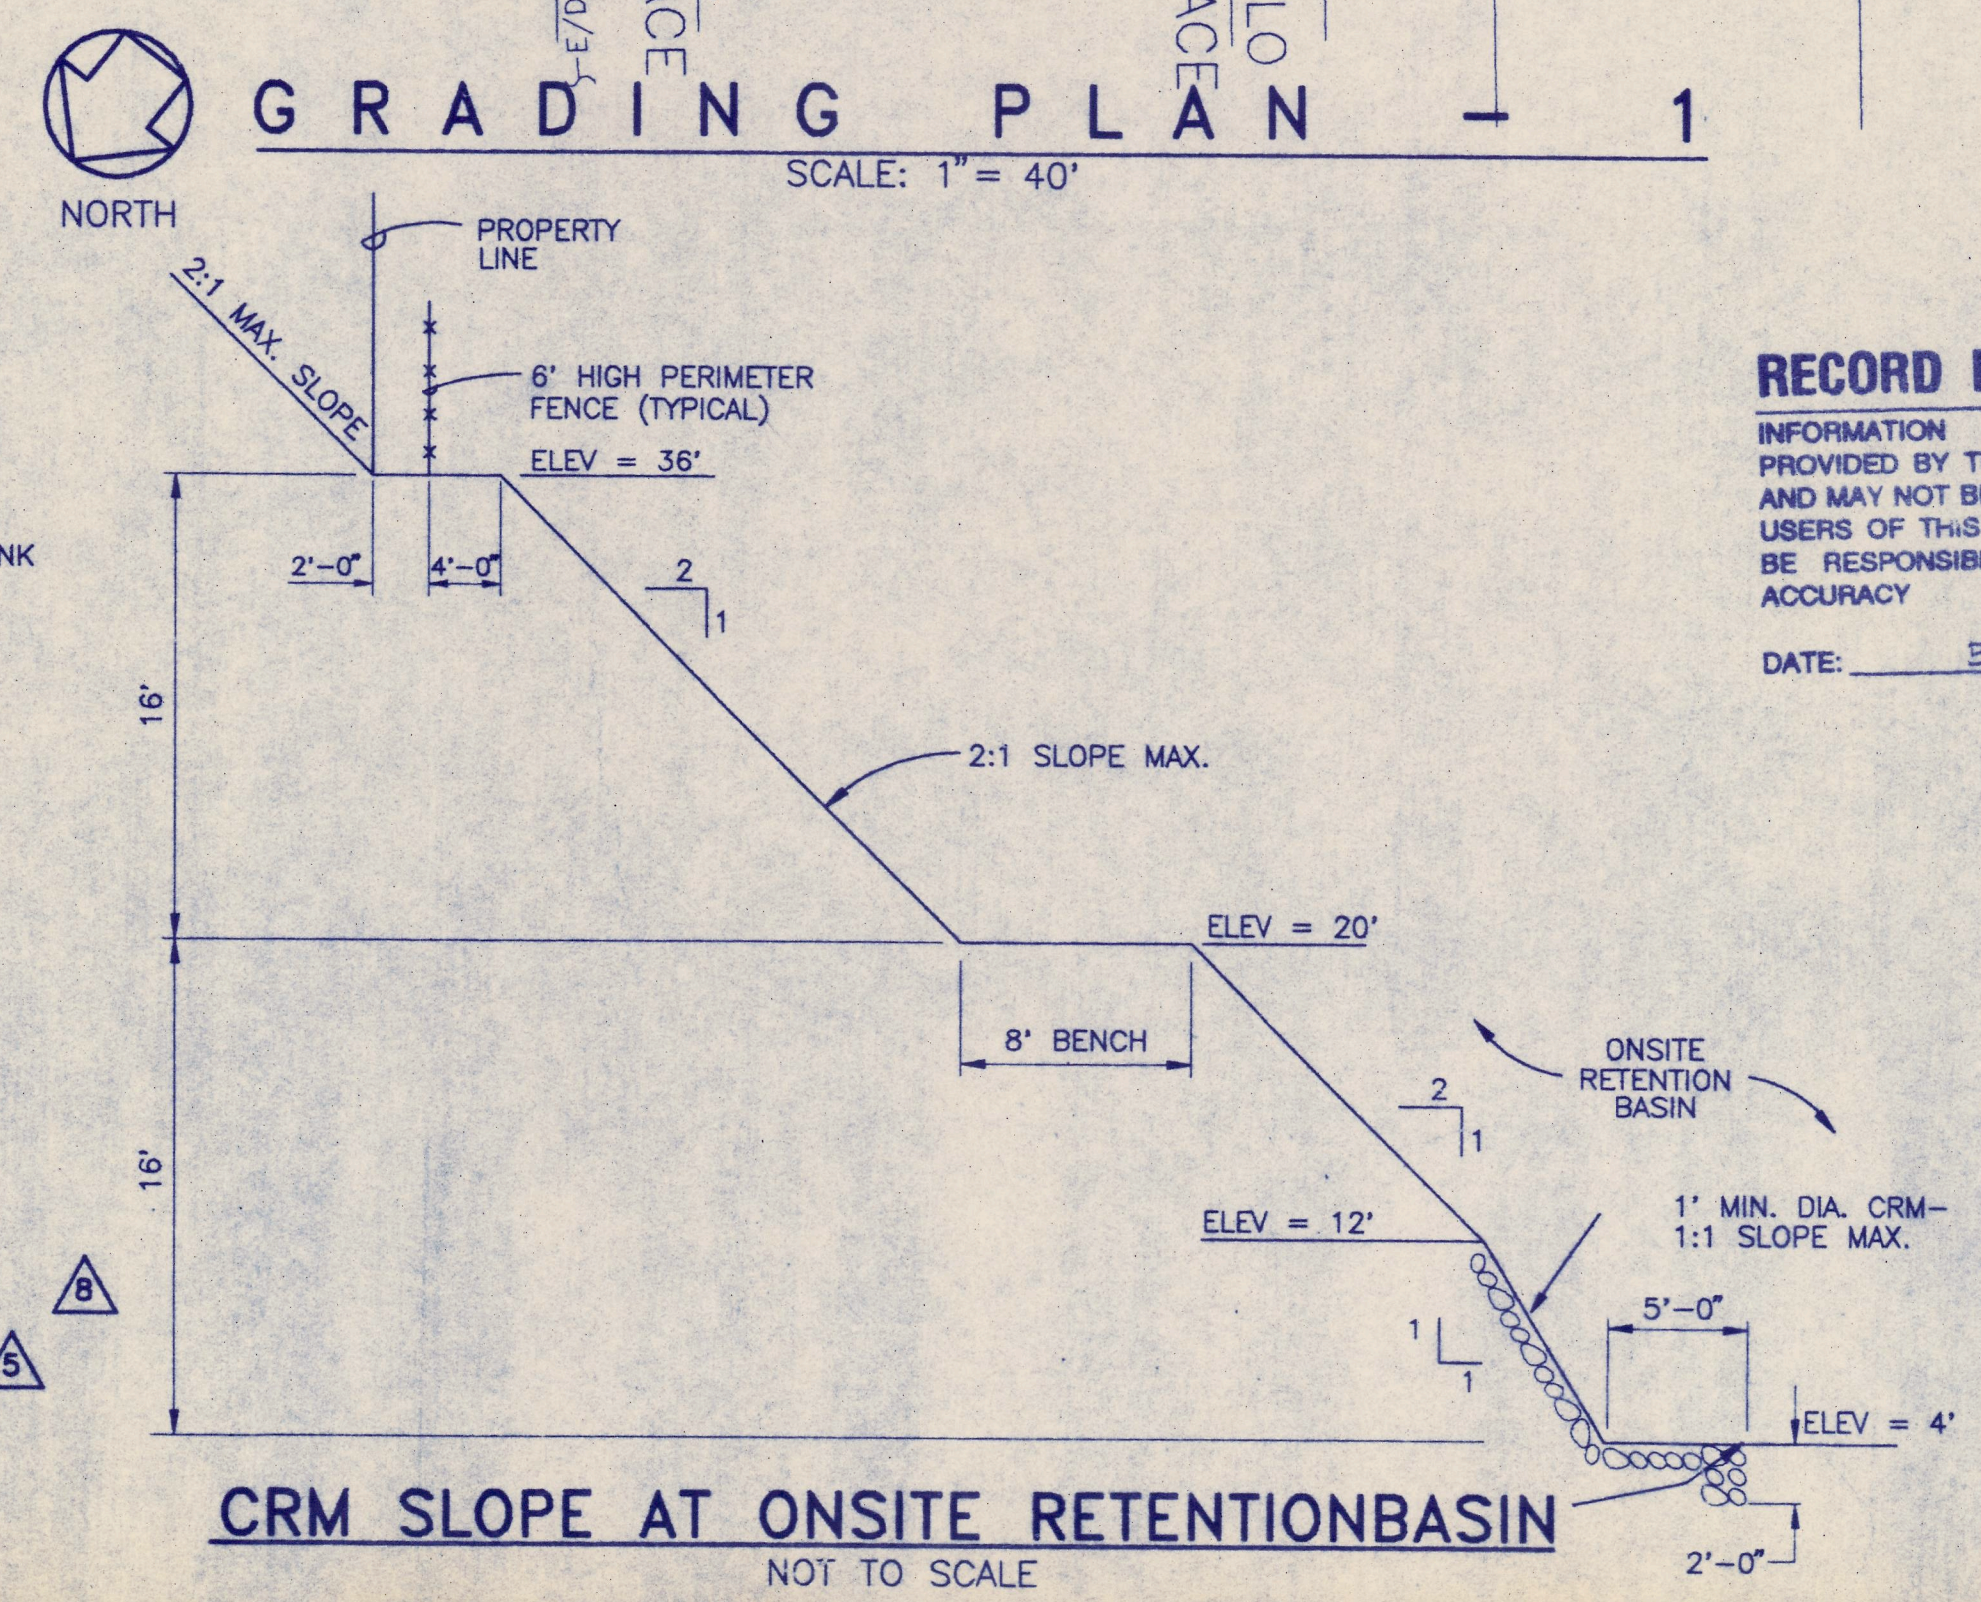


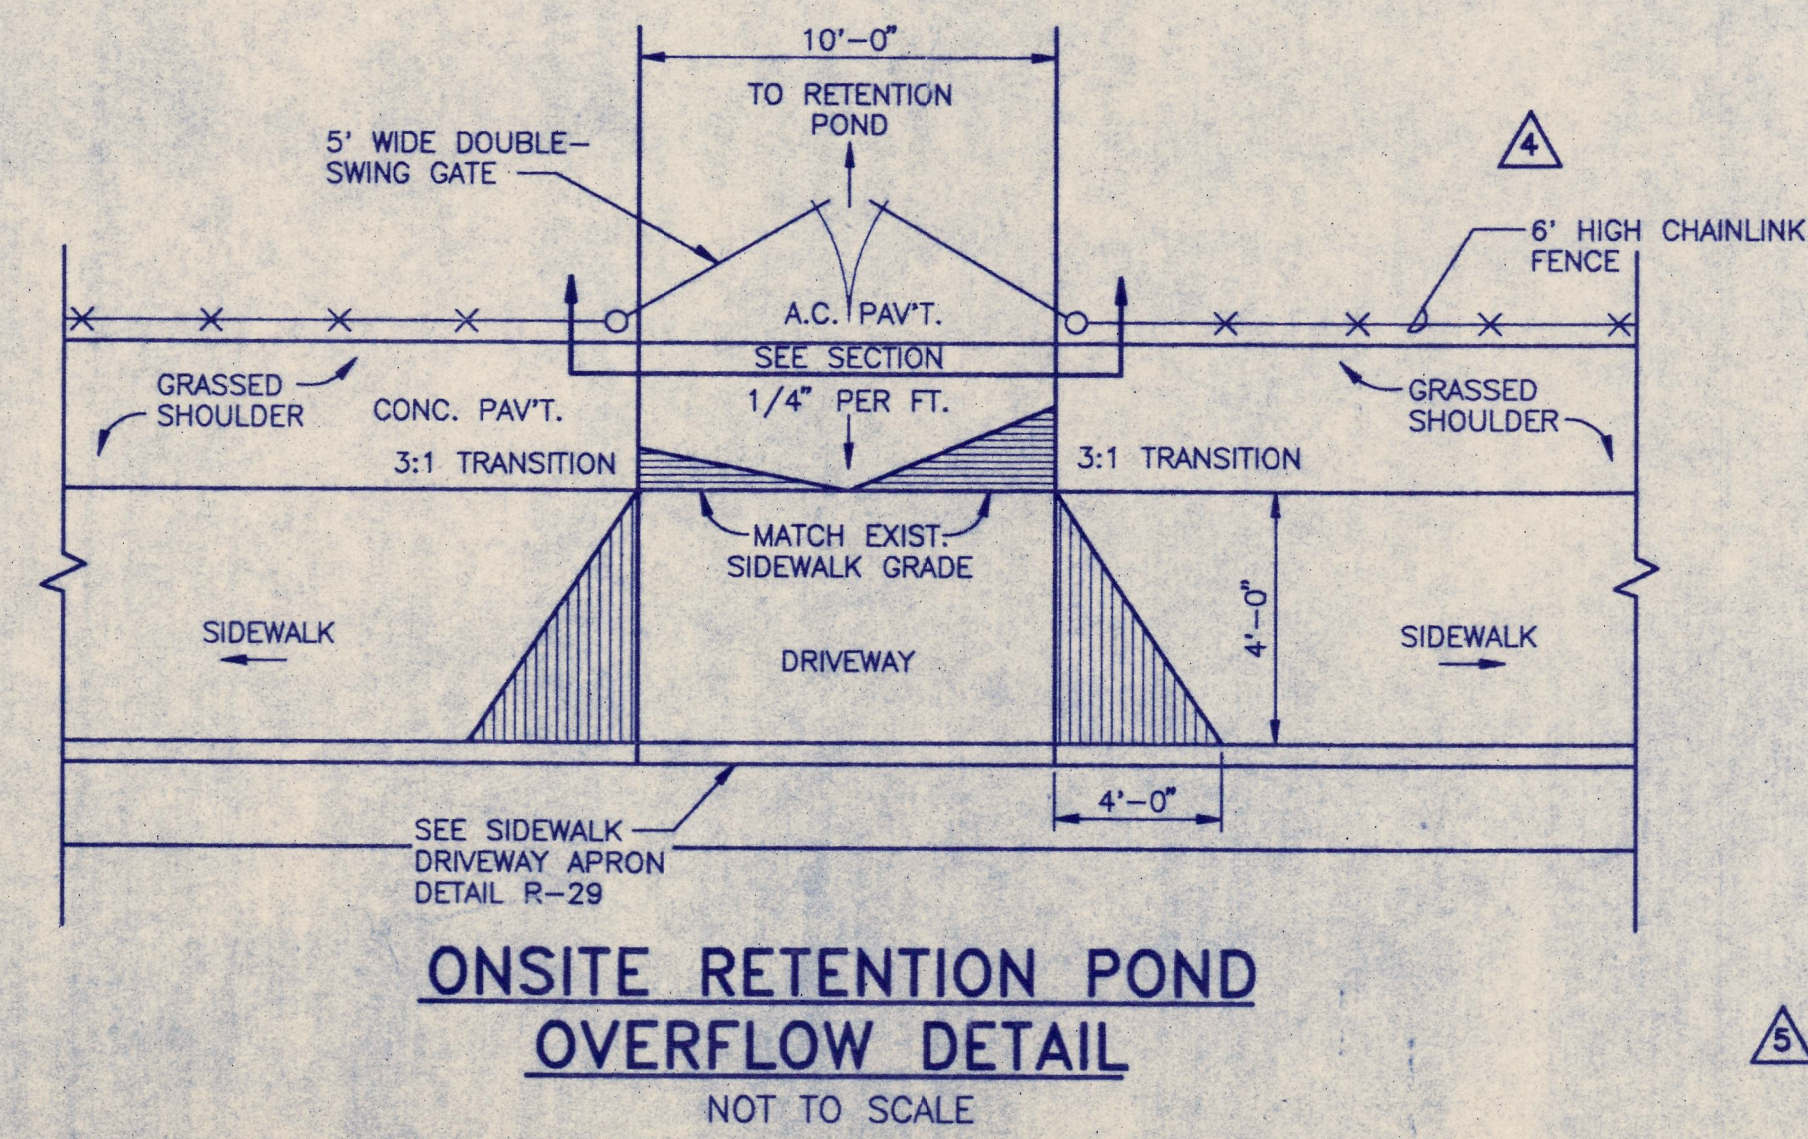

MATCH LINE

- DUST CONTROL:**
1. THE CONTRACTOR, AT HIS EXPENSE, SHALL KEEP THE PROJECT AREA AND SURROUNDING AREA FREE FROM DUST NUISANCE. THE WORK SHALL BE IN CONFORMANCE WITH THE AIR POLLUTION CONTROL STANDARDS AND REGULATIONS OF THE STATE OF DEPARTMENT OF HEALTH.
 2. THE CONTRACTOR SHALL PROVIDE DUST CONTROL WITH SPRINKLERS AND/OR WATERWAGONS AS NECESSARY, WEEKENDS AND HOLIDAYS INCLUDED. ALL GRADED AREAS SHALL BE THOROUGHLY WATERED AFTER CONSTRUCTION ACTIVITY HAS CEASED FOR THE DAY AND FOR THE WEEKEND.
- GRASSING:**
1. THE CONTRACTOR, AT HIS EXPENSE,

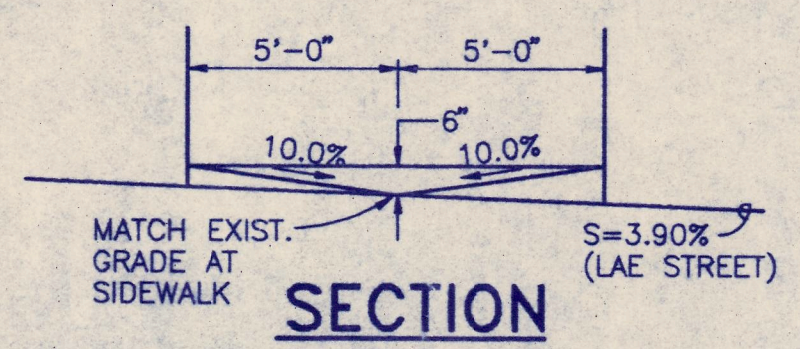

RECORD DRAWINGS
INFORMATION SHOWN WAS PROVIDED BY THE CONTRACTOR AND MAY NOT BE ACCURATE. THE USERS OF THIS DRAWING SHALL BE RESPONSIBLE TO VERIFY ITS ACCURACY.
DATE: 5/8/94

DATE: 12/22/94
SCALE: AS SHOWN
DESIGN BY: M.I.
DRAWN BY: N.M.
CHECKED BY: B.R.T.

BERT R. TOBA
LICENSED PROFESSIONAL ENGINEER
No. 4556-C
HAWAII, U.S.A.

THIS WORK WAS PREPARED BY ME OR UNDER MY SUPERVISION

11	REVISED GRADING	10/6/95
10	ADDITIONAL COMMENTS PER D.O.T. (DRAINAGE AND ROAD IMPROVEMENTS)	9/22/95
9	LOT GRADING	7/20/95
8	REVISED GRADES AT ONSITE RETENTION BASIN.	6/19/95
7	REPLACED SDMH WITH CATCH BASIN PER D.O.T. COMMENTS.	6/19/95
6	OFFSITE DRAINAGE REVISIONS	5/17/95
5	ADDENDUM #3 SLOPE STABILIZATION WALL DELETED	5/1/95
4	REVISIONS AFTER BID	4/24/95

SATO & ASSOCIATES, INC.
CONSULTING ENGINEERS • CIVIL & STRUCTURAL
HONOLULU, OAHU, HAWAII • WAILUKU, MAUI, HAWAII

MAKANA SUBDIVISION
T.M.K.: 2-5-05: 57
PAIA, HAMAKUAPOKO, MAUI, HAWAII

GRADING PLAN-1	
APPROVED:	APPROVED:
DATE	DATE
DATE	DATE

