




DUST CONTROL:


1. THE CONTRACTOR, AT HIS EXPENSE, SHALL KEEP THE PROJECT AREA AND SURROUNDING AREA FREE FROM DUST NUISANCE. THE WORK SHALL BE IN CONFORMANCE WITH THE AIR POLLUTION CONTROL STANDARDS AND REGULATIONS OF THE STATE OF DEPARTMENT OF HEALTH.
2. THE CONTRACTOR SHALL PROVIDE DUST CONTROL WITH SPRINKLERS AND/OR WATERWAGONS AS NECESSARY, WEEKENDS AND HOLIDAYS INCLUDED. ALL GRADED AREAS SHALL BE THOROUGHLY WATERED AFTER CONSTRUCTION ACTIVITY HAS CEASED FOR THE DAY AND FOR THE WEEKEND.

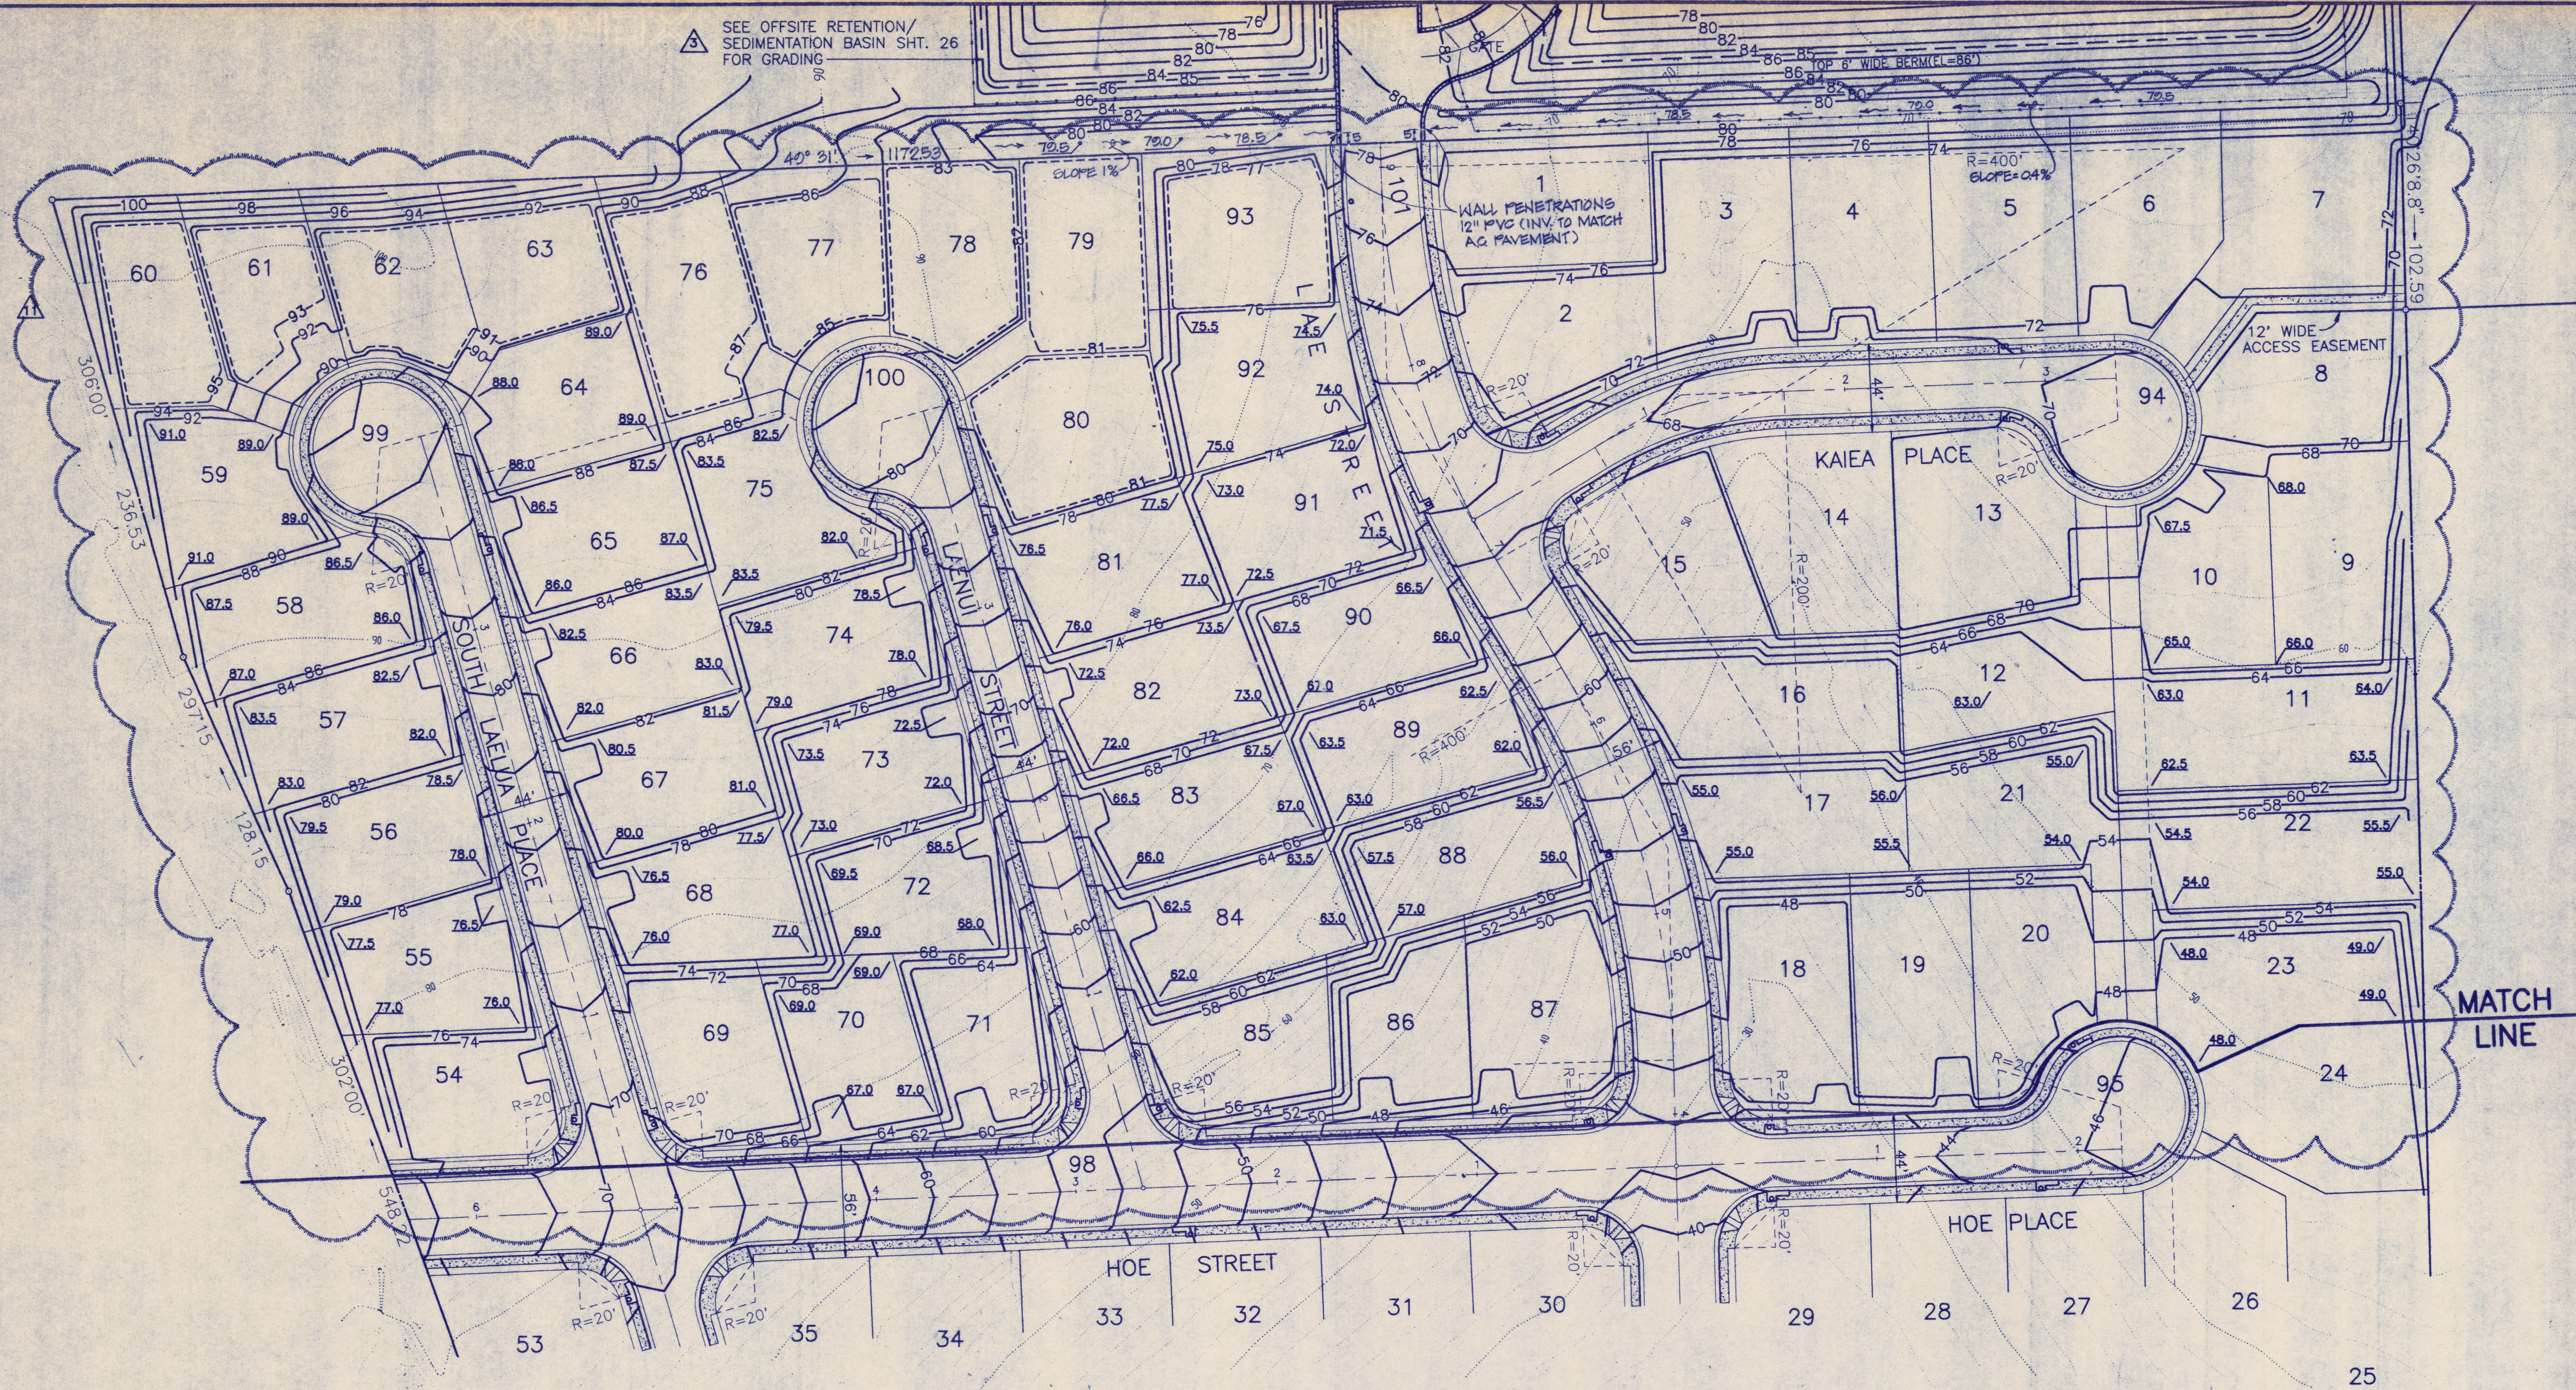

GRADING PLAN - 2

SCALE: 1" = 40'

RECORD DRAWINGS
 INFORMATION SHOWN WAS PROVIDED BY THE CONTRACTOR AND MAY NOT BE ACCURATE. THE USERS OF THIS DRAWING SHALL BE RESPONSIBLE TO VERIFY ITS ACCURACY.
 DATE: 5/8/96

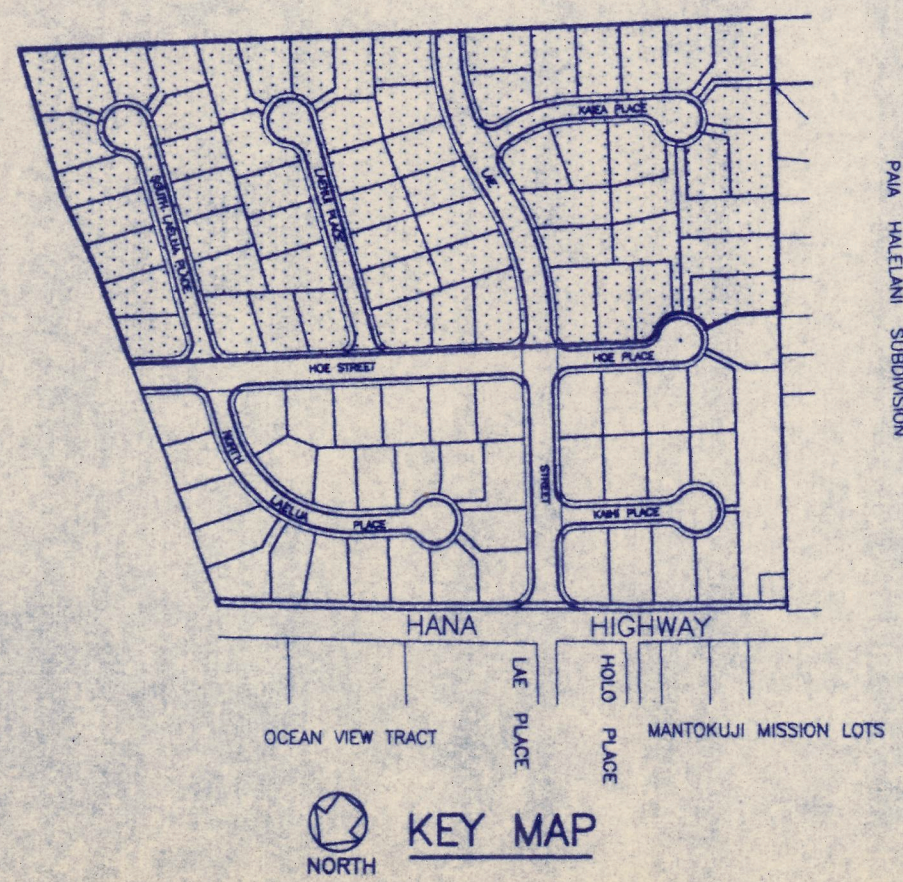

11	REVISED GRADING	10/8/95
3	ADDENDUM #3	4/24/95
SATO & ASSOCIATES, INC. CONSULTING ENGINEERS • CIVIL & STRUCTURAL HONOLULU, OAHU, HAWAII • WAILUKU, MAUI, HAWAII		
MAKANA SUBDIVISION T.M.K.: 2-5-05: 57 PAIA, HAMAKUPOKO, MAUI, HAWAII		
GRADING PLAN-2		
APPROVED:	APPROVED:	
DATE	DATE	
DATE	DATE	

DATE: 12/22/94
 SCALE: AS SHOWN
 DESIGN BY: M.J.
 DRAWN BY: N.M.
 CHECKED BY: B.R.T.

BERT R. TOBA
 LICENSED PROFESSIONAL ENGINEER
 No. 4556-C
 HAWAII, U.S.A.

THIS WORK WAS PREPARED BY ME OR UNDER MY SUPERVISION