As-Built

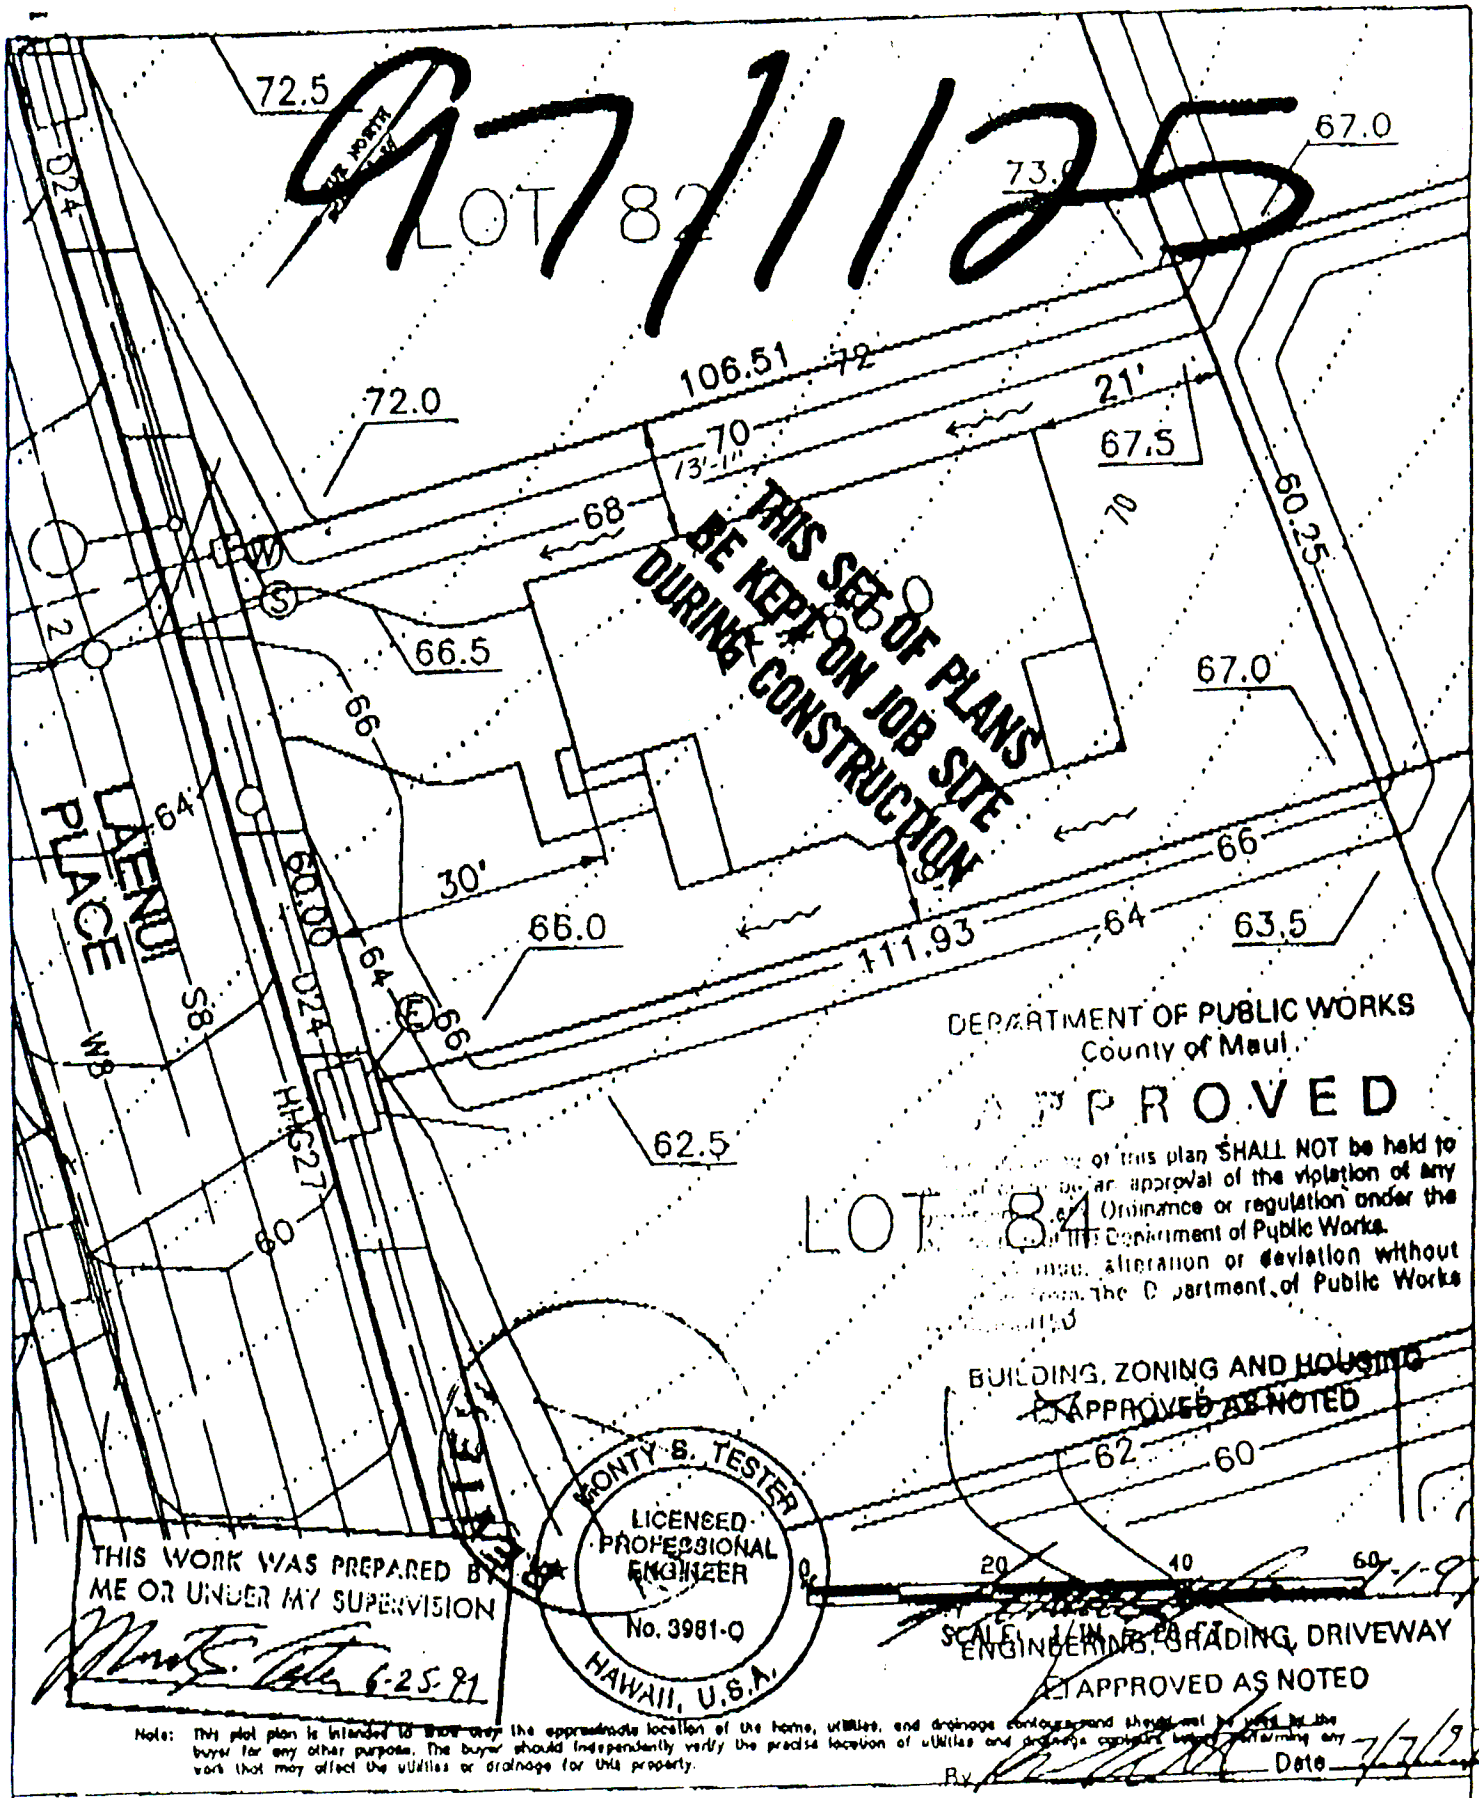

Note: This plot plan is intended to show only the approximate location of the home, utilities, and drainage contours and shall not be used by the buyer for any other purpose. The buyer should independently verify the precise location of utilities and drainage contours before performing any work that may affect the utilities or drainage for this property.

Plot Plan For Lot: 83

House Color:	Model No.: 1300
House Trim Color:	File Plan Lot No.:
Roof Color:	T.M.K.: